Bonner County Planning Department

"Protecting property rights and enhancing property value" 1500 Highway 2, Suite 208, Sandpoint, Idaho 83864 Phone (208) 265-1458 - Fax (866) 537-4935 Email: <u>planning@bonnercountyid.gov</u> - Web site: <u>www.bonnercountyid.gov</u>

Blueline Collective Report Memorandum

To: Mann Holdings C, Inc.

From: Rob Winningham, Planner

Date: August 20, 2024

Subject: Blue-line review for MLD0031-24: BLUEGRASS MEADOWS

Attached are comments from various agencies that have completed the preliminary review of the referenced plat.

The digital copy of the Mylar is required per BCRC 12-649. Please email your digital copy to planning@bonnercountyid.gov.

The blue-line copy of the plat containing corrections and comments has been forwarded to your representative: **Dan Provolt**.

Please submit payment of **\$308.14** covering the County Surveyor's fee for the review of the plat and the fee for a conformed copy. Please make checks payable to Bonner County Planning Department.

WHEN THE FINAL PLAT MYLAR IS SUBMITTED, THE FOLLOWING MUST BE COMPLETED:

- ✓ All plat corrections.
- ✓ Endorsement by the County Treasurer of the Treasurer's certificate. All taxes must be paid in full for entire current tax year, both June and December, to obtain the Treasurer's endorsement.
- ✓ Letters of approval for roads, water, sewer, or any other conditions or improvements required for the plat.
- $\checkmark~$ All conditions of approval must be met.
- Endorsement of owner's certificate and acknowledgments, project surveyor certificate and all lienholder certificates and acknowledgments.
- ✓ County surveyor fee paid to the Bonner County Planning Department.

REMEMBER TO RETURN CORRECTED BLUE-LINE WITH MYLARS.

Please contact the Bonner County Planning Department if you have any questions regarding this plat or the review process.



Bonner County Planning Department "Protecting property rights and enhancing property value" 1500 Highway 2, Suite 208, Sandpoint, Idaho 83864 Phone (208) 265-1458 - Fax (866) 537-4935 Email: <u>planning@bonnercountyid.gov</u> - Web site: <u>www.bonnercountyid.gov</u>

Blueline Review Routing Form



Plat Name:	File No:	
BLUEGRASS MEADOWS	MLD0031-24	
Received by:	Received from:	Date Received:
Rob Winningham, Planner	Dan Provolt	July 1, 2024

Blueline Review

Completed	Date	Initial	Department/ Office
Х	8/20/2024	RW	Bonner County Planning Department
X	7/2/2024	AB	Assessor's Office
Comment	7-3-24	MM	Bonner County Road & Bridge Department
See letter	7/2/2024	MC	GIS Department
X	7/5/2021	TLAG	County Surveyor



Bonner County Planning Department

"Protecting property rights and enhancing property value"

1500 Highway 2, Suite 208, Sandpoint, Idaho 83864

Phone: 208-265-1458

Email: planning@bonnercountyid.gov Website:www.bonnercountyid.gov

MINOR LAND DIVISION ADMINISTRATIVE STAFF REPORT DECISION

FILE #:MLD0031-24APPLICANT:Mann Holdings C, LlcSUBDIVISION NAME/LOTS:Bluegrass Meadows

DATE OF REPORT: 8/20/2024 PARCEL #: RP56N02W094800A

SUMMARY OF PROPOSAL:

The applicant is proposing to divide a 9.8-acre parcel into one (1) 5-acre lot and one (1) 4.8-acre lot.

THE APPLICATION IS consistent, subject to conditions, with Bonner County Revised Code as evidenced in the record submitted up to the time the staff report was prepared, with the addition of findings and conditions listed in this staff report, subject to the conclusions required by BCRC.

CONDITIONS OF APPROVAL:

1. A final plat shall be recorded

2. The preliminary plat of a minor land division shall be valid for a period not to exceed two (2) calendar years from the date of approval. Within two (2) years of the approval of the preliminary plat, the applicant shall submit the final plat to the Planning Director. At any time prior to the expiration date of the preliminary plat, an applicant may make a written request to the Planning Director for an extension of the preliminary plat for a period up to two (2) years. The Planning Director may consider such request for extension. The extension request must be approved or denied prior to the expiration date of the preliminary plat.

3. Obtain an Administrative Exception for lot size minimum to allow for a 4.8-acre lot where 5.0-acres is required.

4. Show access easement and instrument number for Lot 1.

5. Remove structures from plat.

6. Label Spades Rd, specify that it is a County maintained public road, show ROW width, and indicate how that ROW was established.

STANDARDS REVIEW:

DOES PROJECT MEET ZONING DISTRICT M 12-660 (D) (2) (f) Site area minimum:	MINIMUMS? No	No Rural 5 (R-5) Urban services:	Νο
DOES PROJECT CONFORM TO SUBDIVISIO	N DESIGN C	CRITERIA?	
Has the applicant had Panhandle Health District lift the sanitary restrictions on the property?:	Νο	In an area of City impact:	Νο
12-660 (D) (2) (a) Alignment with existing/planned roads/easements:	Yes	12-621 Depth to width/ Angle of intersection:	Yes
12-660 (D) (2) (g) Not divided by city, county,	Yes	12-622 Submerged Lands:	N/A
zoning, or public R-O-W boundaries:		12-626.A Environmental Features:	Yes

FINDINGS:

1. This proposal was reviewed for compliance with the criteria and standards set forth at Section 12-600, et seq., Bonner County Revised Code.

1. Slopes - The site does contain mapped slopes per USGS.

2. Wetlands - The site does not contain mapped wetlands per NWI.

3. Waterfront - The site does not contain frontage on a river, stream or lake.

4. FEMA - Parcel is within SFHA Zone AE and SFHA Zone X per FIRM Panel Number 16017C0950E, Effective Date 11/18/2009. No further floodplain review is required on this proposal.

5. Services - The parcel is served by individual well, individual septic system, Sagle Fire District, Avista and Lake Pend Oreille School District #84.

6. The parcel is not platted.

7. The current land use is Rural Residential (5-10 AC) and the current zoning is Rural 5 (R-5).

8. Access - Access is via Spades Road. This is a county owned and maintained public right of way.

9. Deed - The applicant purchased the parcel on May 24, 2024 per Instrument No. 1033707, Records of Bonner County.

NOTICE OF ADMINISTRATIVE DECISION:

Planning Director has determined that the above-cited application is in accord with Section 12-661, Bonner County Revised Code, as set forth in the findings and conclusions contained herein. This determination may be appealed to the Board of County Commissioners by notifying the Planning Director in writing of the intent to appeal within ten (10) working days from the date of the determination. Upon receipt of an appeal, the Planning Director will schedule a meeting with the Board within ten (10) working days to hear the appeal and will provide written notice to the appellant of the time and place of the meeting. The Planning Director and appellant will be provided an opportunity to present the relevant issues to the Board at that meeting. The Board's decision shall be final and further recourse of the appellant shall be to the Courts as provided by law. If no appeal is filed, the Planning Director's decision will be deemed effective.

NOTE: Following any final decision concerning a site-specific land use request, the applicant has a right to request a regulatory taking analysis pursuant to Section 67-8003, Idaho Code (Idaho Code §67-6535(c)).

Sincerely,

Planning Department

Bonner County Planning Department

"Protecting property rights and enhancing property value" 1500 Highway 2, Suite 208, Sandpoint, Idaho 83864 Phone (208) 265-1458 - Fax (866) 537-4935 Email: <u>planning@bonnercountyid.gov</u> - Web site: <u>www.bonnercountyid.gov</u>

Blueline Review Letter

August 20, 2024

Dan Provolt Provolt Land Surveying PO Box 580 Ponderay ID 83852

SUBJECT: MLD0031-24: BLUEGRASS MEADOWS

Dear Dan,

The above referenced project has been reviewed. The following conditions should be addressed:

- Submit the fee for the County Surveyor and the Recorder.
- Submit the digital file (.dwg format) for the Final Plat at time of Mylar submittal.
- Complete the corrections and additions included with the blue-line review attached with this letter.
 - o Planning
 - See Conditions on Planning Department's Administrative Staff Report/ Decision Letter.
 - o Floodplain
 - Parcel is within SFHA Zone X per FIRM Panel Number 16017C0950E, Effective Date 11/18/2009. No further floodplain review is required on this proposal.
 - Assessors
 - See letter from Assessor.
 - o GIS
 - See letter from GIS.
 - County Surveyor
 - See letter from County Surveyor.
 - Road and Bridge
 - See comments on plat.

Thank you for your submittal and the opportunity to review.

Sincerely,

Rob Winningham Planner





Bonner County Geographic Information Systems

1500 Highway 2 Suite 115 • Sandpoint, ID 83864 • Phone: (208) 255-3630 ext. 1469 E-mail: gisgroup@bonnercountyid.gov

Tuesday, July 2, 2024

Bonner County Planning Department

RE: PLAT REVIEW – BLUEGRASS MEADOWS (MLD0031-24) SECTION 9, TOWNSHIP 56N, RANGE 2W

To Whom It May Concern:

After reviewing the proposed plat I have found no errors in road naming. All names are either existing roads within Bonner County or have been reserved.

Please create and show the Ingress, Egress & Utility Easement for Lot 1.

Sincerely,

Michael Bolling Director, GIS Bonner County, ID 1500 Highway 2 Suite 115 Sandpoint, ID 83864 Website: https://www.bonnercountyid.gov/departments/GIS/gis



Office of Dennis Engelhardt **Bonner County Assessor** 1500 Hwy 2, Suite 205 Sandpoint, ID 83864 Phone 208-265-1440 www.bonnercountyid.gov/departments/ Assessor

July 2, 2024

Bonner County Planning Dept BLUEGRASS MEADOWS MLD0031-24 SECTION 9, TOWNSHIP 56 NORTH, RANGE 2 WEST RP56N02W094800A


To whom this may concern:

I have reviewed the Owners' Certificate of the above named plat and did not find any obvious errors with the ownership.

Please verify ownership again when this plat goes to mylar.

Thank you,

Andrea Ballard GIS Technician Bonner County GIS 208-265-1469 landrecords@bonnercountyid.gov

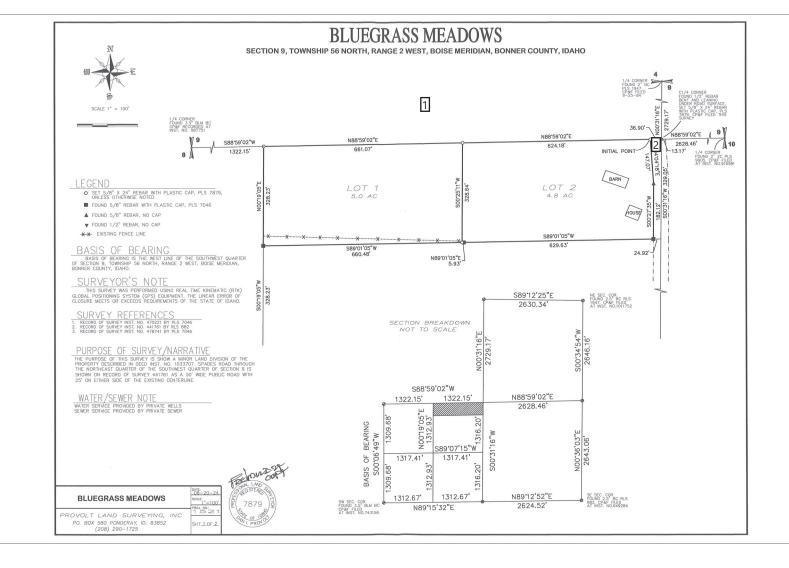

Summary of Comments on MLD0031-24 Preliminary Plat.pdf


Page: 1


 Number: 1
 Author: Monica Carash
 Date: 7/2/2024 9:39:21 AM

 Ingress & Egress easement for Lot 1?
 Ingress & Egress easement for Lot 1?

Number: 2 Author: Matt Mulder Date: 7/3/2024 9:33:41 AM

Label Spades Rd, specify that it is a County maintained public road, show ROW width, and indicate how that ROW was established.

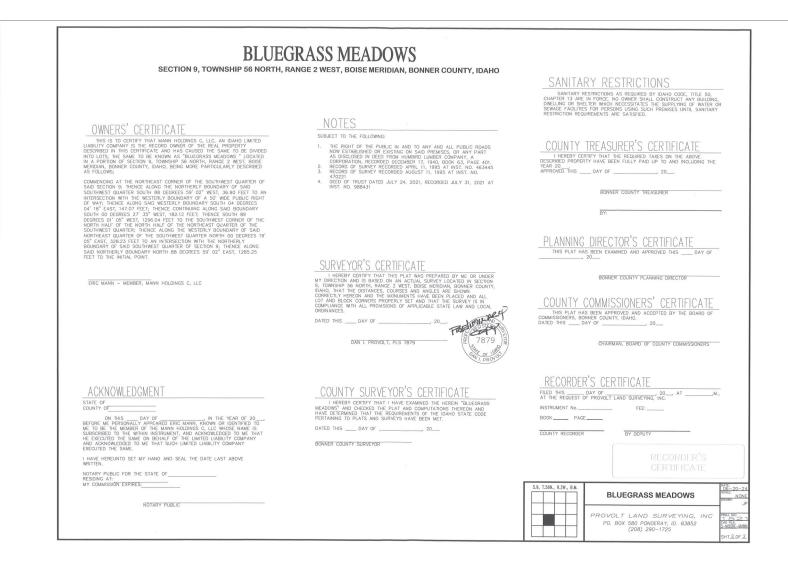

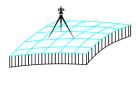

303 Church St. P.O. Box 1863 Sandpoint, ID 83864 Phone: (208) 265-4474 Fax: (208) 265-0675 E-mail: manager@glaheinc.com Website: www.glaheinc.com

July 5, 2024

Bonner County Planning Dept. 1500 Hwy. 2, Suite 208 Sandpoint, ID 83864

Re: Plat Review – MLD0031-24 – Bluegrass Meadows

Dear Planning Dept.,

I have examined the above-mentioned plat and find the following corrections or additions to be made:

- 1) Note C1/4 CP&F on final plat.
- 2) Show access to Lot 1 and monument accordingly.
- 3) Annotate and show status of Spades Road.
- 4) Show status of adjacent properties.

When these items have been addressed, the plat should be ready for signature.

Sincerely,

Tyson L.A. Glahe, PLS

GLAHE & ASSOCIATES, INC. , Professional Land Surveyors

303 Church St. P.O. Box 1863 Sandpoint, ID 83864

Invoice #

Bill To:

Provolt

Phone: (208) 265-4474 Fax: (208) 265-4474 E-mail: manager@glaheinc.com Website: www.glaheinc.com

Date

7/15/2024

Project / Job #

24-001CE Review MLD0031-24 - Bluegrass Me

Please submit payment by: 7/30/2024 INVOICE

14730


	Section	Township	Range	Meridian	Tax Parcel ID	
		Description			Amount	
Copies	Surveyor Review & Recording Fees 031-24 - Bluegrass Meado	ws				265.00 43.14
				Retainer	/ Credits:	\$0.00
	Square	PayPal	venmo	Invoice	Amount:	\$308.14
© 2503 Square, Inc. Square and Pre-	lgen tige en helmeste d'Egen. In: Othe despedet believels wetende en the property of the regenties even	umseos.e		Job Tota	al Balance Due:	\$308.14

THANK YOU FOR YOUR BUSINESS

ALL INVOICES ARE DUE UPON RECEIPT

BILLS 30 DAYS PAST DUE WILL BE SUBJECT TO A LATE CHARGE OF 1.5% PER MONTH OR AN ANNUAL PERCENTAGE OF 18%

A 3% FEE WILL BE CHARGED ON CREDIT CARD, PAYPAL & VENMO PAYMENTS [PAYMENT AMOUNT x 1.03%]

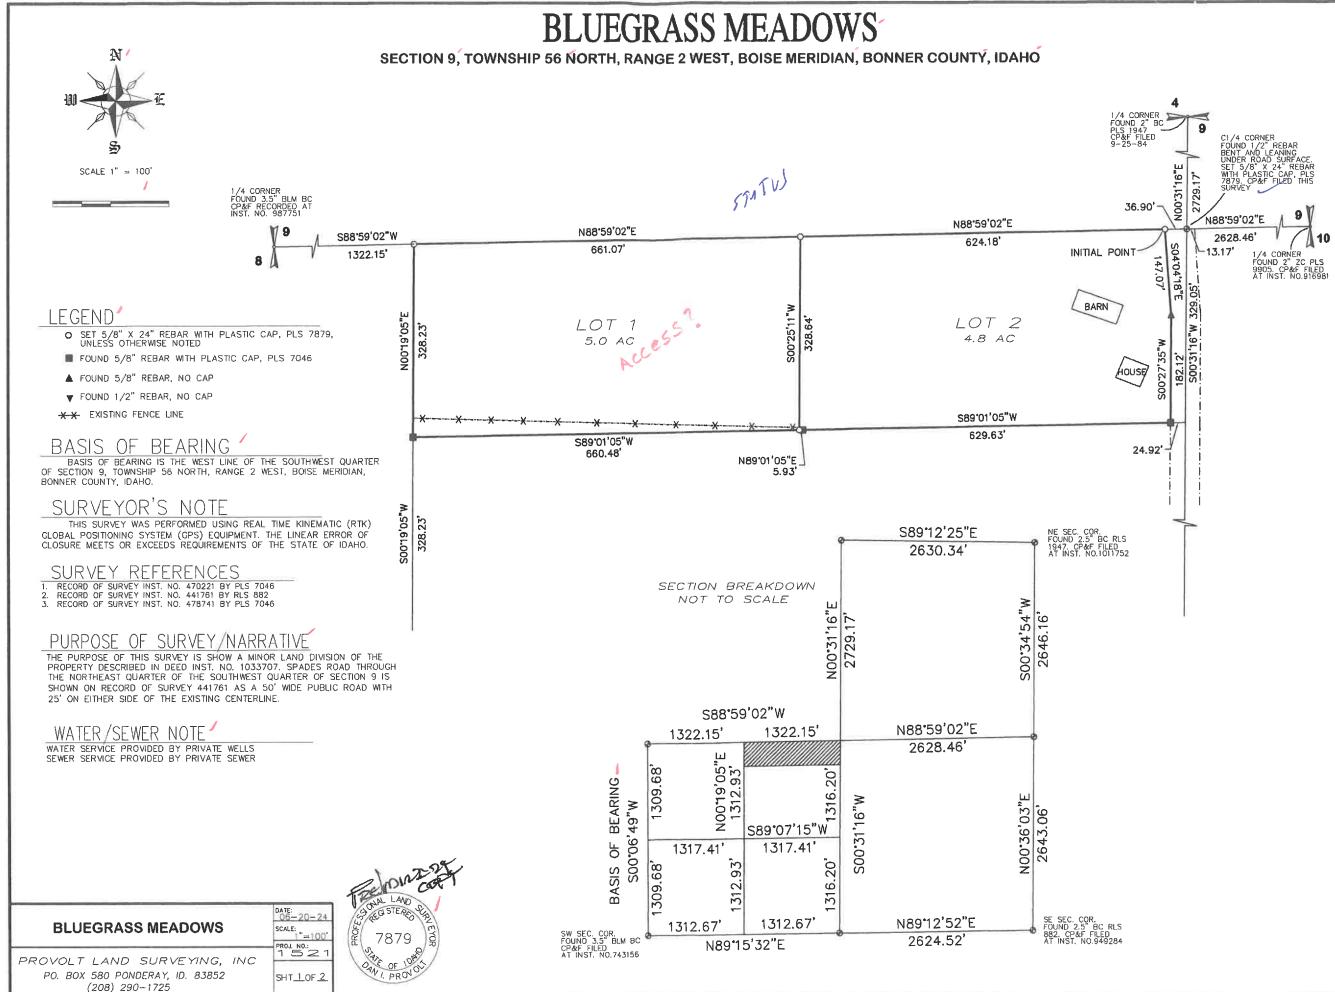

BLUEGRASS MEADOWS

SECTION 9, TOWNSHIP 56 NORTH, RANGE 2 WEST, BOISE MERIDIAN, BONNER COUNTY, IDAHO

OWNERS' CERTIFICATE

THIS IS TO CERTIFY THAT MANN HOLDINGS C, LLC, AN IDAHO LIMITED LIABILITY COMPANY IS THE RECORD OWNER OF THE REAL PROPERTY DESCRIBED IN THIS CERTIFICATE AND HAS CAUSED THE SAME TO BE DIVIDED INTO LOTS, THE SAME TO BE KNOWN AS "BLUEGRASS MEADOWS " LOCATED IN A PORTION OF SECTION 9, TOWNSHIP 56 NORTH, RANGE 2 WEST, BOISE MERIDIAN, BONNER COUNTY, IDAHO, BEING MORE PARTICULARLY DESCRIBED AS FOLLOWS:

COMMENCING AT THE NORTHEAST CORNER OF THE SOUTHWEST QUARTER OF SAID SECTION 9; THENCE ALONG THE NORTHERLY BOUNDARY OF SAID SOUTHWEST QUARTER SOUTH 88 DEGREES 59' 02" WEST, 36.90 FEET TO AN INTERSECTION WITH THE WESTERLY BOUNDARY OF A 50' WIDE PUBLIC RIGHT OF WAY; THENCE ALONG SAID WESTERLY BOUNDARY SOUTH 04 DEGREES 04' 18" EAST, 147.07 FEET; THENCE CONTINUING ALONG SAID BOUNDARY SOUTH OO DEGREES 27' 35" WEST, 182.12 FEET; THENCE SOUTH 89 DEGREES 01' 05" WEST, 1296.04 FEET TO THE SOUTHWEST CORNER OF THE NORTH HALF OF THE NORTH HALF OF THE NORTHEAST QUARTER OF THE SOUTHWEST QUARTER; THENCE ALONG THE WESTERLY BOUNDARY OF SAID NORTHEAST QUARTER OF THE SOUTHWEST QUARTER NORTH OD DEGREES 19' 05" CAST, 328.23 FEET TO AN INTERSECTION WITH THE NORTHERLY BOUNDARY OF SAID SOUTHWEST QUARTER OF SECTION 9; THENCE ALONG SAID NORTHERLY BOUNDARY NORTH 88 DEGREES 59' 02" EAST, 1285.25 FEET TO THE INITIAL POINT

ERIC MANN - MEMBER, MANN HOLDINGS C, LLC

ACKNOWI FDGMENT

STATE OF COUNTY OF

ON THIS ____ DAY OF _____ IN THE YEAR OF 20___ BEFORE ME PERSONALLY APPEARED ERIC MANN, KNOWN OR IDENTIFIED TO ME TO BE THE MEMBER OF THE MANN HOLDINGS C, LLC WHOSE NAME IS SUBSCRIBED TO THE WITHIN INSTRUMENT, AND ACKNOWLEDGED TO ME THAT HE EXECUTED THE SAME ON BEHALF OF THE LIMITED LIABILITY COMPANY AND ACKNOWLEDGED TO ME THAT SUCH LIMITED LIABILITY COMPANY EXECUTED THE SAME

I HAVE HEREUNTO SET MY HAND AND SEAL THE DATE LAST ABOVE WRITTEN

NOTARY PUBLIC FOR THE STATE OF RESIDING AT: MY COMMISSION EXPIRES:

NOTARY PUBLIC

NOTES

SUBJECT TO THE FOLLOWING:

- THE RIGHT OF THE PUBLIC IN AND TO ANY AND ALL PUBLIC ROADS 1 NOW ESTABLISHED OR EXISTING ON SAID PREMISES, OR ANY PART AS DISCLOSED IN DEED FROM HUMBIRD LUMBER COMPANY, A CORPORATION, RECORDED DECEMBER 17, 1940, BOOK 63, PAGE 401. RECORD OF SURVEY RECORDED APRIL 11, 1995 AT INST. NO. 463445 RECORD OF SURVEY RECORDED AUGUST 11, 1995 AT INST. NO.
- 470221
- DEED OF TRUST DATED JULY 24, 2021, RECORDED JULY 31, 2021 AT 4 INST. NO. 988431



SEWAGE FACILITIES FOR RESTRICTION REQUIREMI

COUNTY TRI

I HEREBY CERTIFY DESCRIBED PROPERTY HA YEAR 20_ APPROVED THIS ____ DA



20


DAY

I HEREBY CERTIFY THAT THIS PLAT WAS PREPARED BY ME OR UNDER MY DIRECTION AND IS BASED ON AN ACTUAL SURVEY LOCATED IN SECTION 9, TOWNSHIP 56 NORTH, RANGE 2 WEST, BOISE MERIDIAN, BONNER COUNTY, IDAHO, THAT THE DISTANCES, COURSES AND ANGLES ARE SHOWN CORRECTLY HEREON AND THE MONUMENTS HAVE BEEN PLACED AND ALL LOT AND BLOCK CORNERS PROPERLY SET AND THAT THE SURVEY IS IN COMPLIANCE WITH ALL PROVISIONS OF APPLICABLE STATE LAW AND LOCAL ORDINANCES.

20____

DATED THIS ____ DAY OF

DAN I. PROVOLT, PLS 7879

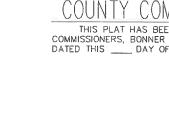


COUNTY SURVEYOR'S

I HEREBY CERTIFY THAT I HAVE EXAMINED THE HEREIN "BLUEGRASS MEADOWS" AND CHECKED THE PLAT AND COMPUTATIONS THEREON AND HAVE DETERMINED THAT THE REQUIREMENTS OF THE IDAHO STATE CODE PERTAINING TO PLATS AND SURVEYS HAVE BEEN MET.


DATED THIS ____ DAY OF ____ 20____

BONNER COUNTY SURVEYOR

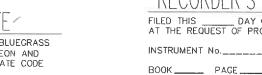

7879

COUNTY RECORDER

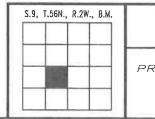

RESTRICTIONS-	
CTIONS AS REQUIRED BY IDAHO CODE, TITLE 50, DRCE. NO OWNER SHALL CONSTRUCT ANY BUILDING, WHICH NECESSITATES THE SUPPLYING OF WATER OF PERSONS USING SUCH PREMISES UNTIL SANITARY ENTS ARE SATISFIED.	2
EASURER'S CERTIFICATE	
BONNER COUNTY TREASURER	
BY:	
RECTOR'S CERTIFICATE	
BONNER COUNTY PLANNING DIRECTOR	
MISSIONERS' CERTIFICATE N APPROVED AND ACCEPTED BY THE BOARD OF COUNTY, IDAHO. 20	
CHAIRMAN, BOARD OF COUNTY COMMISSIONERS	
OF 20 AT	
BY DEPUTY	
BLUEGRASS MEADOWS	DATE: 06-20-24 SCALE: DRAWN: JP
ROVOLT LAND SURVEYING, INC PO. BOX 580 PONDERAY, ID. 83852 (208) 290–1725	PROJ. NO.: 1 5 2 1 CAD FILE: S-MOORE-MANN SHT_2_OF_2

Invers	e With Area	To	TAL		Thu Jun 20 14:23:04 2024
PntNo PP	Bearing	Distance	Northing 2388596.10	Easting 2421391.99	Description
	N 88°59'02" E	1285.25			
PP			2388618.89	2422677.04	
0.05	S 04°04'18" E	147.07	0000470.00		
205	S 00°27'35" W	100 10	2388472.20	2422687.48	
PP	5 00 27 55 W	102.12	2388290.08	2422686.02	
	S 89°01'05" W	1296.04		0 0 0 0 0 0 2	
PP			2388267.87	2421390.17	
	N 00°19'05" E	328.23			
PP			2388596.10	2421391.99	
Closure Error Distance> 0.0000					
Total Distance Inversed> 3238.71					

Area: 425073.3, 9.8

Invers	e With Area		LI		Thu Jun 20 14:23:32 2024
PntNo PP	Bearing	Distance	Northing 2388596.10	Easting 2421391.99	Description
	N 88°59'02" E	661.07			
PP			2388607.82	2422052.96	
	S 00°25'11" W	328.64			
PP	_		2388279.19	2422050.55	
	S 89°01'05" W	660.48			
PP			2388267.87	2421390.17	
D D	N 00°19'05" E	328.23	0000E0C 10	0401201 00	
PP			2388596.10	2421391.99	
Closure Error Distance> 0.0000					
Total Distance Inversed> 1978.43					

Area: 216960.8, 5.0

"Invers	e With Area		L2		Thu Jun 20 14:24:27 2024
PntNo PP	Bearing	Distance	Northing 2388607.82	Easting 2422052.96	Description
PP	N 88°59'02" E		2388618.89	2422677.04	
205	S 04°04'18" E S 00°27'35" W		2388472.20	2422687.48	
PP	S 89°01'05" W		2388290.08	2422686.02	
PP	N 00°25'11" E	328.64	2388279.19	2422050.55	
	e Error Distan Distance Inver			2422052.96	

Area: 208112.5, 4.8