# **Bonner County Planning Department**

"Protecting property rights and enhancing property value" 1500 Highway 2, Suite 208, Sandpoint, Idaho 83864 Phone (208) 265-1458 - Fax (866) 537-4935 Email: <u>planning@bonnercountyid.gov</u> - Web site: <u>www.bonnercountyid.gov</u>

# **Blueline Collective Report Memorandum**

To: Chris Peine

From: Alex Feyen, Planner

Date: October 3, 2024

# Subject: Blue-line review for MLD0039-24 Peine Subdivision

Attached are the comments from various agencies that have completed the preliminary review of the referenced plat.

The blue-line copy of the plat containing corrections and comments has been forwarded to your representative: **Glahe & Associates**.

Please submit payment of **\$308.14** covering the County Surveyor's fee of for the review of the plat and the fee for a conformed copy. Please make checks payable to Bonner County Planning Department.

# WHEN THE FINAL PLAT MYLAR IS SUBMITTED, THE FOLLOWING MUST BE COMPLETED:

✓ All plat corrections.

- ✓ Endorsement by the County Treasurer of the Treasurer's certificate. All taxes must be paid in full for entire current tax year, both June and December, to obtain the Treasurer's endorsement.
- ✓ County surveyor fee paid to the Bonner County Planning Department.
- ✓ Letters of approval for roads, water, sewer, or any other conditions or improvements required for the plat.
- $\checkmark~$  All conditions of approval must be met.
- Endorsement of owner's certificate and acknowledgments, project surveyor certificate and all lienholder certificates and acknowledgments.

# REMEMBER TO RETURN CORRECTED BLUE-LINE WITH MYLARS.

Please contact the Bonner County Planning Department if you have any questions regarding this plat or the review process.



Bonner County Planning Department "Protecting property rights and enhancing property value" 1500 Highway 2, Suite 208, Sandpoint, Idaho 83864 Phone (208) 265-1458 - Fax (866) 537-4935 Email: <u>planning@bonnercountyid.gov</u> - Web site: <u>www.bonnercountyid.gov</u>

# **Blueline Review Routing Form**



| Plat Name:<br><b>Peine Subdivision</b> |                    | File No:<br><b>MLD0039-24</b> |  |
|--|--------------------|-------------------------------|--|
| Received by:                           | Received from:     | Date Received:                |  |
| Rob Winningham, Planner                | Glahe & Associates | 8/12/2024                     |  |

# **Blueline Review**

| Completed | Date      | Initial | Department/ Office                     |
|-----------|-----------|---------|--|
| Х         | 10/3/2024 | AF      | Bonner County Planning Department      |
| comments  | 8/12/2024 | AB      | Assessor's Office                      |
| Х         | 8-13-24   | MM      | Bonner County Road & Bridge Department |
| MC        | 8/12/2024 | MC      | GIS Department                         |
| X         | 8/23/2024 | JLA     | County Surveyor                        |



# **Bonner County Planning Department**

"Protecting property rights and enhancing property value"

1500 Highway 2, Suite 208, Sandpoint, Idaho 83864

Phone: 208-265-1458

Email: planning@bonnercountyid.gov Website:www.bonnercountyid.gov

# MINOR LAND DIVISION ADMINISTRATIVE STAFF REPORT DECISION

FILE #:

Chris Peine

**APPLICANT:** 

SUBDIVISION NAME/LOTS: Peine Subdivision

**DATE OF REPORT: 10/3/2024** PARCEL #: RP56N03W025550A

# **SUMMARY OF PROPOSAL:**

Divide one (1) 20.21-acre parcel into one (1) 10.08-acre lot and one (1) 10.09-acre lot.

MLD0039-24

THE APPLICATION IS consistent, subject to conditions, with Bonner County Revised Code as evidenced in the record submitted up to the time the staff report was prepared, with the addition of findings and conditions listed in this staff report, subject to the conclusions required by BCRC.

# **CONDITIONS OF APPROVAL:**

1. A final plat shall be recorded.

2. The preliminary plat of a minor land division shall be valid for a period not to exceed two (2) calendar years from the date of approval. Within two (2) years of the approval of the preliminary plat, the applicant shall submit the final plat to the Planning Director. At any time prior to the expiration date of the preliminary plat, an applicant may make a written request to the Planning Director for an extension of the preliminary plat for a period up to two (2) years. The Planning Director may consider such request for extension. The extension request must be approved or denied prior to the expiration date of the preliminary plat.

3. Per BCRC 12-411(Setbacks) The buildings do not need to be on plat. A separate site plan showing existing structures and their setbacks to the proposed property lines and road needs to be submitted to ensure compliant setbacks will be maintained.

4. PER BCRC 12-646(M): The wetland boundaries shown on the NWS shall be indicated on the final plat.

5. Per BCRC 12-646 (C): The initial point or POB shall be identified.

# **STANDARDS REVIEW:**

**DOES PROJECT MEET ZONING DISTRICT MINIMUMS?** 10-acre Rural 10 (R-10)

12-660 (D) (2) (f) Site area minimum: Yes

# DOES PROJECT CONFORM TO SUBDIVISION DESIGN CRITERIA?

Has the applicant had Panhandle Health District

lift the sanitary restrictions on the property?: No

12-660 (D) (2) (a) Alignment with existing/planned roads/easements: **Yes** 

12-660 (D) (2) (g) Not divided by city, county, zoning, or public R-O-W boundaries: **Yes** 

In an area of City impact: No

12-621 Depth to width/ Angle of intersection: Yes12-622 Submerged Lands: N/A12-626.A Environmental Features: Yes

# FINDINGS:

1. This proposal was reviewed for compliance with the criteria and standards set forth at Section 12-600, et seq., Bonner County Revised Code.

2. The proposed lots are zoned Rural-10.

3. The proposed lots are served by individual wells and individual septic systems.

4. The proposed lots are located off Lakeshore Drive, a Bonner County owned and maintained public right-of-way.

5. The proposed lots are served by Sagle Fire District and Pacific Power Light Company.

6. The proposed lots do contain an intermittent stream and mapped wetland.

## NOTICE OF ADMINISTRATIVE DECISION:

Planning Director has determined that the above-cited application is in accord with Section 12-661, Bonner County Revised Code, as set forth in the findings and conclusions contained herein. This determination may be appealed to the Board of County Commissioners by notifying the Planning Director in writing of the intent to appeal within ten (10) working days from the date of the determination. Upon receipt of an appeal, the Planning Director will schedule a meeting with the Board within ten (10) working days to hear the appeal and will provide written notice to the appellant of the time and place of the meeting. The Planning Director and appellant will be provided an opportunity to present the relevant issues to the Board at that meeting. The Board's decision shall be final and further recourse of the appellant shall be to the Courts as provided by law. If no appeal is filed, the Planning Director's decision will be deemed effective.

NOTE: Following any final decision concerning a site-specific land use request, the applicant has a right to request a regulatory taking analysis pursuant to Section 67-8003, Idaho Code (Idaho Code §67-6535(c)).

Sincerely,

Planning Department

# **Bonner County Planning Department**

"Protecting property rights and enhancing property value" 1500 Highway 2, Suite 208, Sandpoint, Idaho 83864 Phone (208) 265-1458 - Fax (866) 537-4935 Email: <u>planning@bonnercountyid.gov</u> - Web site: <u>www.bonnercountyid.gov</u>

# **Blueline Review Letter**

October 3, 2024

Glahe & Associates 303 Church Street Sandpoint, ID 83864

# SUBJECT: MLD0039-24 Peine Subdivision

Dear Project Representative,

# The above referenced project has been reviewed. The following conditions should be addressed:

- Submit the fee for the County Surveyor and the Recorder.
- Submit the digital file (.dwg format) for the Final Plat at time of Mylar submittal.
- Complete the corrections and additions included with the blue-line review attached with this letter.
  - o Planning
    - See Conditions on Planning Department's Administrative Staff Report/ Decision Letter.
  - Floodplain
    - JRJ, 8.12.2024: Parcel is FIRM Panel Number 16017C0925E, Effective Date 11/18/2009. No further floodplain review is required on this proposal.
  - Assessors
    - See letter from Assessor.
  - o GIS
    - See letter from GIS.
  - County Surveyor
    - See letter from County Surveyor.
  - Road and Bridge
    - See comments on plat.

Thank you for your submittal and the opportunity to review.

Sincerely Alex Feyen

Alex Feye Planner





# **Bonner County** Geographic Information Systems 1500 Highway 2 Suite 115 • Sandpoint, ID 83864 • Phone: (208) 255-3630 ext. 1469

E-mail: gisgroup@bonnercountyid.gov

Monday, August 12, 2024

Bonner County Planning Department

### PLAT REVIEW - PEINE SUBDIVISION (MLD0039-24) RE: SECTION 2, TOWNSHIP 56N, RANGE 3W

To Whom It May Concern:

After reviewing the proposed plat I have found no errors in road naming. All names are either existing roads within Bonner County or have been reserved.

Sincerely,

Michael Bolling Director, GIS Bonner County, ID 1500 Highway 2 Suite 115 Sandpoint, ID 83864 Website: https://www.bonnercountyid.gov/departments/GIS/gis



Office of Dennis Engelhardt **Bonner County Assessor** 1500 Hwy 2, Suite 205 Sandpoint, ID 83864 Phone 208-265-1440 www.bonnercountyid.gov/departments/ Assessor

August 12, 2024

Bonner County Planning Dept PEINE SUBDIVISION MLD0039-24 SECTION 2, TOWNSHIP 56 NORTH, RANGE 3 WEST RP56N03W025550A

To whom this may concern:

I have reviewed the Owners' Certificate of the above named plat. Please address the following:

Include the full Trust name in Owners' Certificate & Notary Acknowledgment


Include signature lines for both trustees

Complete the legal description in the Owners' Certificate - missing POB info, etc

Please verify ownership again when this plat goes to mylar.

Thank you,

Andrea Ballard GIS Technician Bonner County GIS 208-265-1469 landrecords@bonnercountyid.gov

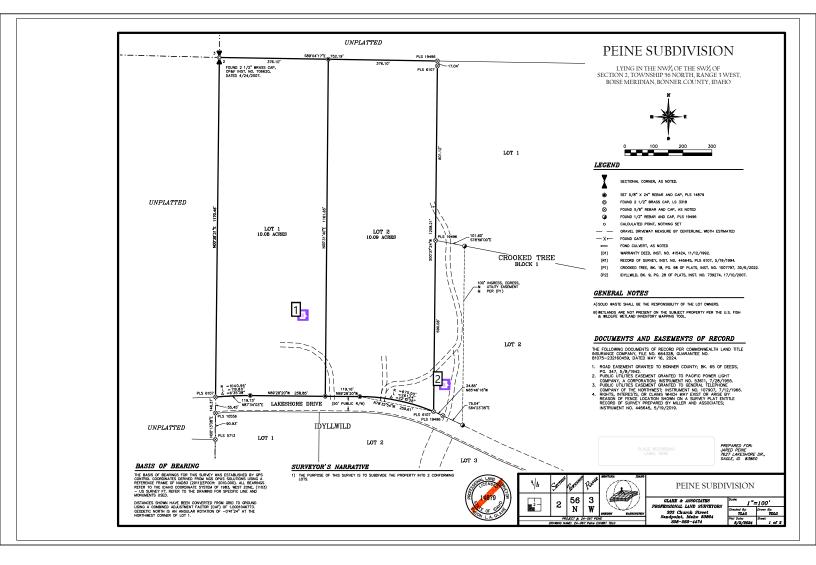

# Summary of Comments on DEVELOPMENT REVIEW

# Page: 1

| Number: 1      | Author: alexander.feyen      | Subject: Sticky Note | Date: 10/3/2024 4:53:58 PM |  |
|----------------|------------------------------|----------------------|----------------------------|--|
| Wetland and in | termittent stream is missing |                      |                            |  |
| ) Number: 2    | Author: alexander.feyen      | Subject: Sticky Note | Date: 10/3/2024 4:42:46 PM |  |

POB missing


|  | PEINE SUBDIVISION  |   |
|--|--|---|
|  | LYING IN THE NW% OF THE SW% OF<br>SECTION 2, TOWNSHIP 56 NORTH, RANGE 3 WEST,<br>BOISE MERIDIAN, BONNER COUNTY, IDAHO  |   |
| OWNERS' CERTIFICATE  | COUNTY COMMISSIONERS' CERTIFICATE  | COUNTY SURVEYOR'S CERTIFICATE   |



|  |  | COUNTY RECORDER BY DEPUTY   |

# Page: 2

| Mumber: 1           | Author: alexander.feyen        | Subject: Sticky Note         | Date: 10/3/2024 4:44:09 PM |  |
|---------------------|--------------------------------|------------------------------|----------------------------|--|
| Chair or Chairwo    | man                            |                              |                            |  |
| T Number: 2         | Author: Andrea Ballard         | Date: 8/12/2024 1:22:24 PM   | 1                          |  |
| CHRIS AND MYR       | NA PEINE LIVING TRUST          |                              |                            |  |
| 👖 Number: 3         | Author: Andrea Ballard         | Date: 8/12/2024 1:22:57 PN   | 1                          |  |
| trustees            |                                |                              |                            |  |
| T Number: 4         | Author: Andrea Ballard         | Date: 8/12/2024 1:25:00 PN   | 1                          |  |
| missing:            |                                |                              |                            |  |
| -                   | r Myrna Peine, Trustee         |                              |                            |  |
| Chris Peine, Truste |                                |                              |                            |  |
| Trust name & rep    | resentative capacity of both s | igners in notary acknowledgm | lent                       |  |
| TNumber: 5          | Author: Andrea Ballard         | Date: 8/12/2024 1:25:23 PN   | 1                          |  |
| incomplete legal    |                                |                              |                            |  |
| Number: 6           | Author: Andrea Ballard         | Date: 8/12/2024 1:08:12 PN   | 1                          |  |

missing POB info

# GLAHE & ASSOCIATES, INC. Professional Land Surveyors

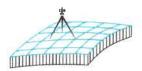

303 Church St. P.O. Box 1863 Sandpoint, ID 83864 Phone: (208) 265-4474 Fax: (208) 265-0675 E-mail: manager@glaheinc.com Website: www.glaheinc.com

August 21, 2024

Bonner County Planning Dept. 1500 Hwy. 2, Suite 208 Sandpoint, ID 83864

Re: Plat Review - MLD0039-24 - Peine Subdivision

Dear Planning Dept.,

I have examined the above-mentioned plat and find the following corrections or additions to be made:

- 1) A line on the plat should be identified as the basis of bearing.
- 2) The linetype identified as gravel driveway is also used for Lakeshore Drive right-of-way.
- 3) Two lines are shown for the south right-of-way of Lakeshore Drive.
- 4) The origin of the public right-of-way for Lakeshore Drive should be identified.
- 5) All easements on site that are plottable should be shown.
- 6) The surveyor's narrative should also state how the boundary and other lines were established.
- 7) The county GIS map shows a wetland and an intermittent stream on the property.
- 8) Other items marked in red on sheets 1 and 2.

When these items have been addressed, the plat should be ready for signature.

Sincerely,

Joel L. andring

Joel L. Andring, PLS

### LAHE&ASSOCIATES INC Drofe .1 т 10


| 03 Church St.           |              |        |              |          |                    |                    |
|-------------------------|--------------|--------|--------------|----------|--------------------|--------------------|
| .O. Box 1863            |              |        |              | Phone:   | (208) 265-4474     | <i>y</i>           |
| andpoint, ID 83864      |              |        |              | Fax:     | (208) 265-4474     |                    |
|                         |              |        |              |          | manager@glahe      |                    |
| Invoice # 148           | 817          |        | W            | /ebsite: | www.glaheinc.c     | om                 |
| Bill To:                |              |        | L            |          | Date               |                    |
| Glahe                   |              |        |              |          | 8/23/2024          |                    |
|                         |              |        |              |          |                    |                    |
|                         |              |        |              | Projec   | t / Job #          |                    |
|                         |              |        | 24-001CP Rev | view ML  | D0039-24 - Peine S | Subdiv             |
| Please submit payment l | by: 9/7/2024 | NVOICE |              |          |                    |                    |
| *******                 | ****         |        | ******       | ******   | *****              |                    |
| Section                 | Township     | Range  | Meridian     |          | Tax Parcel ID      |                    |
|                         |              |        |              |          |                    |                    |
|                         | Description  |        |              |          | Amount             |                    |
| County Surveyor Review  |              |        |              |          |                    | 265.00             |
| Copies & Recording Fees |              |        |              |          |                    | 43.14              |
| MLD0039-24 - Peine Sub  |              |        |              |          |                    |                    |
|                         |              |        |              |          |                    |                    |
|                         |              |        |              |          |                    |                    |
|                         |              |        | Retaine      | r / Cre  | dits:              | \$0.00             |
|                         | PayPal       | venmo  | Retainer     |          |                    | \$0.00<br>\$308.14 |

THANK YOU FOR YOUR BUSINESS

ALL INVOICES ARE DUE UPON RECEIPT

BILLS 30 DAYS PAST DUE WILL BE SUBJECT TO A LATE CHARGE OF 1.5% PER MONTH OR AN ANNUAL PERCENTAGE OF 18%

A 3% FEE WILL BE CHARGED ON CREDIT CARD, PAYPAL & VENMO PAYMENTS [ PAYMENT AMOUNT x 1.03% ]

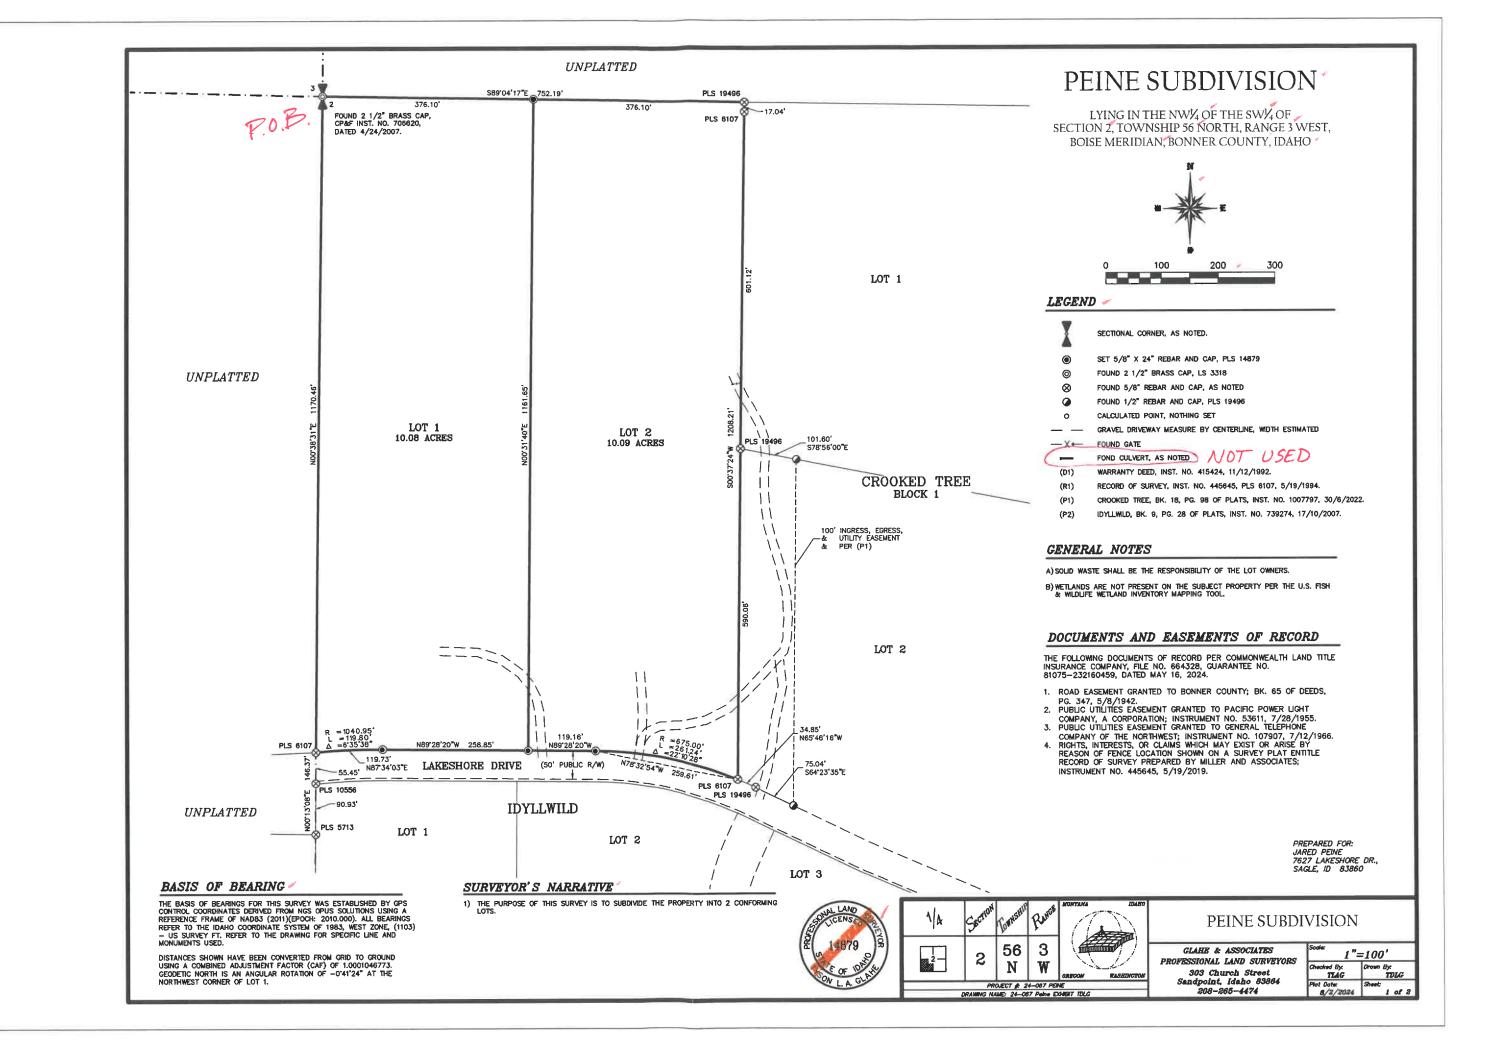

|  |   | PEINE SUBDIVISION  |  |
|--|---|--|--|
|  |   | LYING IN THE NW¼ OF THE SW¼ OF<br>SECTION 2, TOWNSHIP 56 NORTH, RANGE 3 WEST,<br>BOISE MERIDIAN, BONNER COUNTY, IDAHO  |  |
| Need<br>P.O.B.                                       | DIVERS' CERTIFICATE         NOWN ALL MEN BY THESE PRESENTS THAT ONE ALL AD HORA THE COMMANDER COUNTY, HEREBY CERTIFY THAT THEY ARE THE OWNERS OF THE REAL PROPERTY DESCRIBED IN THIS CERTIFICATION THEY CAST THE TO BE PLATTED INTO LOTS 1-2. THE SAME TO DE CNOWN AS 'PENES USUBLISSION' BEING A PORTION OF SECTION 2. TOWNSHIP 56 NORTH, RANGE 3 WEST, BOISE MERIDIAN, BONNER COUNTY, DAHO, MORE SPECIFICALLY DESCRIBED IN THE LEFT AN ARC LENGTH OF 261.24 FEET, A RADIUS OF 75.00 FEET, THE CHORG OF WHICH IS NORTH OF 25'S'A WEST, 259.61 FEET, OA :         THENCE SOUTH 89'04'17' EAST, 752.19 FEET         THENCE SOUTH 89'25'20' WEST, 378.01 FEETO A ;         THENCE ALONG A NON-TANGENT CURVE TO THE LEFT AN ARC LENGTH OF 19.80 FEET, A RADIUS OF 040.95         THENCE NORTH OO'37'30' EAST, 1170.46 FEETO A ;         TH |  | <form><form><form><form><form><form></form></form></form></form></form></form>   |
| Another<br>sig line ŧ<br>acknowledgment<br>for Myrna | ON THIS DAY OF 2024, BEFORE ME, THE<br>UNDERSIGNED NOTARY PUBLIC, PERSONALLY APPEARED CHRIS PEINE, KNOWN OR<br>IDENTIFIED TO ME TO BE THE INDIVIDUAL WHO EXECUTED THE FOREGOING INSTRUMENT.<br>NOTARY PUBLIC<br>NOTARY PUBLIC FOR THE STATE OF<br>RESIDING AT:  | PLANNING DIRECTOR  | WATER AND SEWER NOTE            WATER SERVICE:         WATER TO BE AN INDIVIDUAL WELL<br>SEWER SERVICE:           SEWER SERVICE:         SEWAGE TO BE INDIVIDUAL SEPTIC  |
|  | MY COMMISSION EXPIRES:  | SURVEYOR'S CERTIFICATE<br>I, TYSON L.A. GLAHE, PLS 14879, STATE OF IDAHO. DO HEREBY CERTIFY THAT<br>THIS PLAT WAS PREPARED BY ME OR UNDER MY DIRECTION AND IS BASED ON AN<br>ACTUAL SURVEY LOCATED IN SECTION 2, TOWNSHIP 56 NORTH, RANGE 3 WEST,<br>BOISE MERIDIAN, BONNER COUNTY, IDAHO, THAT THE DISTANCES, COURSES AND<br>ANGLES ARE SHOWN CORRECTLY THEREON AND THAT THE MONUMENTS HAVE BEEN<br>PLACED AND ALL LOT CORNERS PROPERLY SET AND THE SURVEY IS IN<br>COMPLIANCE WITH ALL PROVISIONS OF APPLICABLE STATE LAW AND LOCAL<br>ORDINANCES. | COUNTY TREASURER'S CERTIFICATE   |
|  |   | TYSON L.A. GLAHE, PLS 14879 DATE   | RECORDER'S CERTIFICATE         FILED THISDAY OF, 2024, ATO'CLOCKM.,         IN BOOKOF PLATS AT PAGEAT THE REQUEST OF         GLAHE AND ASSOCIATES, INC., AS INSTRUMENT NO         COUNTY RECORDER       BY DEPUTY         \$         FEE |
|  |   |  |  |

Polyline Report – Both Lots

Fri Aug 2 11:29:59 2024

Northing Easting Bearing Distance

2394433.066 2399436.842

S 89°04'17" E 752.190

2394420.877 2400188.933

S 00°37'24" W 1208.214

- 2393212.735 2400175.788
- Radius: 675.000 Chord: 259.608 Degree: 8°29'18" Dir: Left
- Length: 261.235 Delta: 22°10'28" Tangent: 132.273
- Chord BRG: N 78°32'54" W Rad-In: S 22°32'20" W Rad-Out: S 00°21'52" W
- Radius Point: 2392589.291,2399917.054
- 2393264.278 2399921.348

N 89°28'20" W 378.010

- 2393267.759 2399543.354
- Radius: 1040.950 Chord: 119.733 Degree: 5°30'15" Dir: Left
- Length: 119.799 Delta: 6°35'38" Tangent: 59.966
- Chord BRG: S 87°34'03" W Rad-In: S 00°51'52" W Rad-Out: S 05°43'46" E

Radius Point: 2392226.927,2399527.651

2393262.677 2399423.729

N 00°38'31" E 1170.463

2394433.066 2399436.842

Closure Error Distance> 0.00000

Total Distance> 3889.911

Polyline Area: 878306 sq ft, 20.16 acres

Polyline Report – Lot 1

Fri Aug 2 11:30:12 2024

Northing Easting Bearing Distance

2394426.972 2399812.887

S 00°31'40" W 1161.646

2393265.375 2399802.189

N 89°28'20" W 258.846

- 2393267.759 2399543.354
- Radius: 1040.950 Chord: 119.733 Degree: 5°30'15" Dir: Left
- Length: 119.799 Delta: 6°35'38" Tangent: 59.966
- Chord BRG: S 87°34'03" W Rad-In: S 00°51'52" W Rad-Out: S 05°43'46" E
- Radius Point: 2392226.927,2399527.651
- 2393262.677 2399423.729

N 00°38'31" E 1170.463

2394433.066 2399436.842

S 89°04'17" E 376.095

2394426.972 2399812.887

Closure Error Distance> 0.00000

Total Distance> 3086.849

Polyline Area: 438957 sq ft, 10.08 acres

Polyline Report – Lot 2

Fri Aug 2 11:30:21 2024

Northing Easting Bearing Distance

2394420.877 2400188.933

S 00°37'24" W 1208.214

2393212.735 2400175.788

Radius: 675.000 Chord: 259.608 Degree: 8°29'18" Dir: Left

Length: 261.235 Delta: 22°10'28" Tangent: 132.273

Chord BRG: N 78°32'54" W Rad-In: S 22°32'20" W Rad-Out: S 00°21'52" W

Radius Point: 2392589.291,2399917.054

2393264.278 2399921.348

N 89°28'20" W 119.164

2393265.375 2399802.189

N 00°31'40" E 1161.646

2394426.972 2399812.887


S 89°04'17" E 376.095

2394420.877 2400188.933

Closure Error Distance> 0.00000


Total Distance> 3126.353

Polyline Area: 439350 sq ft, 10.09 acres

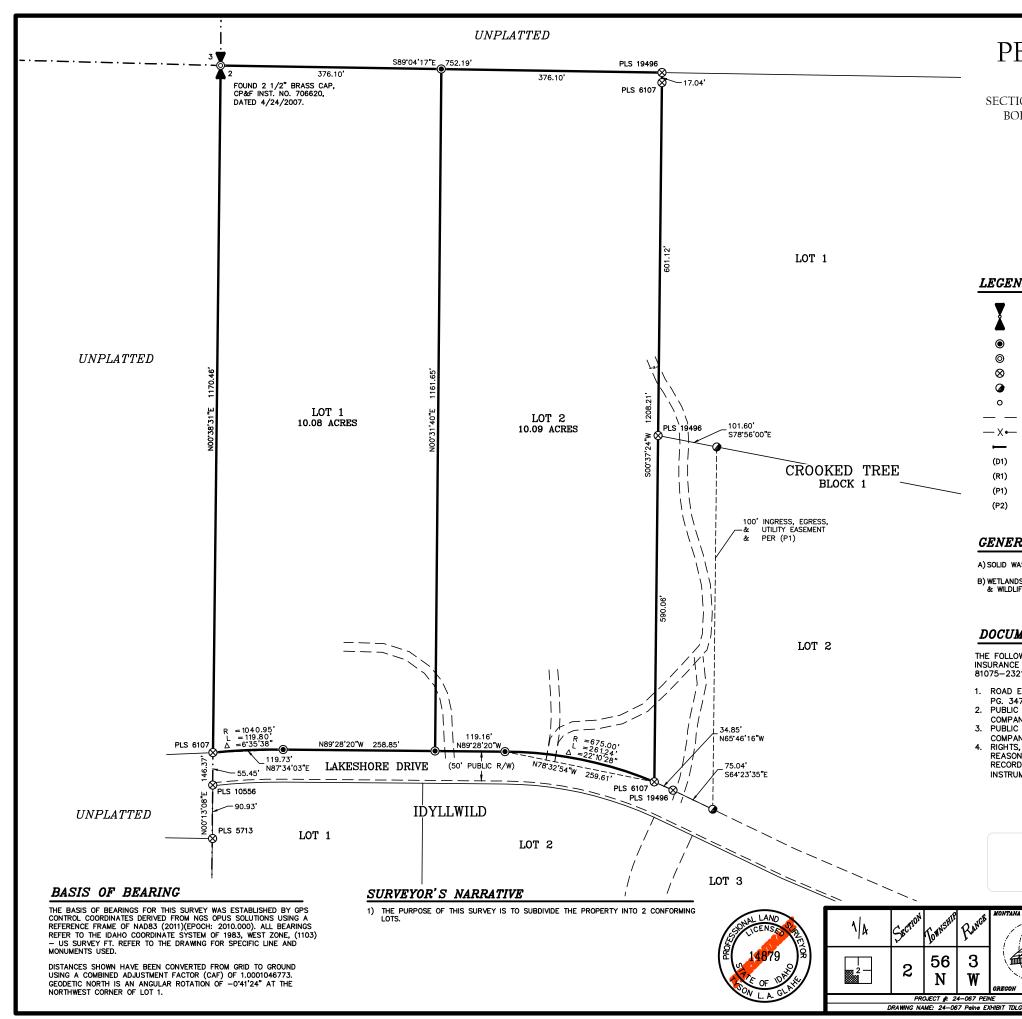

# PEINE SUBDIVISION

LYING IN THE NW<sup>1</sup>/<sub>4</sub> OF THE SW<sup>1</sup>/<sub>4</sub> OF SECTION 2, TOWNSHIP 56 NORTH, RANGE 3 WEST, BOISE MERIDIAN, BONNER COUNTY, IDAHO

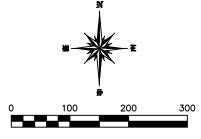

## LEGEND

| X         | SECTIONAL CORNER, AS NOTED.  |
|-----------|--|
| ۲         | SET 5/8" X 24" REBAR AND CAP, PLS 14879                              |
| Ø         | FOUND 2 1/2" BRASS CAP, LS 3318                                      |
| $\otimes$ | FOUND 5/8" REBAR AND CAP, AS NOTED                                   |
| Ø         | FOUND 1/2" REBAR AND CAP, PLS 19496                                  |
| 0         | CALCULATED POINT, NOTHING SET  |
|           | GRAVEL DRIVEWAY MEASURE BY CENTERLINE, WIDTH ESTIMATED               |
| —×⊷       | FOUND GATE   |
| -         | FOND CULVERT, AS NOTED   |
| (D1)      | WARRANTY DEED, INST. NO. 415424, 11/12/1992.                         |
| (R1)      | RECORD OF SURVEY, INST. NO. 445645, PLS 6107, 5/19/1994.             |
| (P1)      | CROOKED TREE, BK. 18, PG. 98 OF PLATS, INST. NO. 1007797, 30/6/2022. |
| (P2)      | IDYLLWILD, BK. 9, PG. 28 OF PLATS, INST. NO. 739274, 17/10/2007.     |

## GENERAL NOTES

A) SOLID WASTE SHALL BE THE RESPONSIBILITY OF THE LOT OWNERS.

B) WETLANDS ARE NOT PRESENT ON THE SUBJECT PROPERTY PER THE U.S. FISH & WILDLIFE WETLAND INVENTORY MAPPING TOOL.

## DOCUMENTS AND EASEMENTS OF RECORD

THE FOLLOWING DOCUMENTS OF RECORD PER COMMONWEALTH LAND TITLE INSURANCE COMPANY, FILE NO. 664328, GUARANTEE NO. 81075-232160459, DATED MAY 16, 2024.

- 1. ROAD EASEMENT GRANTED TO BONNER COUNTY; BK. 65 OF DEEDS,

 ROAD EASEMENT GRANIED TO BONNER COUNTY; BK. 65 OF DEEDS, PG. 347, 5/8/1942.
 PUBLIC UTILITIES EASEMENT GRANTED TO PACIFIC POWER LIGHT COMPANY, A CORPORATION; INSTRUMENT NO. 53611, 7/28/1955.
 PUBLIC UTILITIES EASEMENT GRANTED TO GENERAL TELEPHONE COMPANY OF THE NORTHWEST; INSTRUMENT NO. 107907, 7/12/1966.
 RIGHTS, INTERESTS, OR CLAIMS WHICH MAY EXIST OR ARISE BY REASON OF FENCE LOCATION SHOWN ON A SURVEY PLAT ENTITLE DECODE OF SUBJECT DEPEADED BY MULLEP AND ASSOCIATES: RECORD OF SURVEY PREPARED BY MILLER AND ASSOCIATES; INSTRUMENT NO. 445645, 5/19/2019.

PREPARED FOR: JARED PEINE 7627 LAKESHORE DR., SAGLE, ID 83860 PEINE SUBDIVISION GLAHE & ASSOCIATES 1"=100' PROFESSIONAL LAND SURVEYORS ked By: TLAG rawn By: **TDLG** 303 Church Street Sandpoint, Idaho 83864 WASHIN ot Date: 8/2/2024 208-265-4474 " 1 of 2

| PEINE SUBDIVISION |
|-------------------|
|-------------------|

LYING IN THE NW1/4 OF THE SW1/4 OF SECTION 2, TOWNSHIP 56 NORTH, RANGE 3 WEST, BOISE MERIDIAN, BONNER COUNTY, IDAHO

COUNTY COMMISSIONERS' CERTIFICATE

DATED THIS \_\_\_\_\_ DAY OF \_\_\_\_\_, 2024.

CHAIRMAN, BOARD OF BONNER COUNTY COMMISSIONERS

THIS PLAT HAS BEEN APPROVED AND ACCEPTED BY THE BOARD OF COUNTY COMMISSIONERS, BONNER COUNTY, IDAHO.

### OWNERS' CERTIFICATE

KNOWN ALL MEN BY THESE PRESENTS THAT CHRIS PENE AND MYRNA PENE, CO-OWNERS OF PENE TRUST, HEREBY CERTIFY THAT THEY ARE THE OWNERS OF THE REAL PROPERTY DESCRIBED IN THIS CERTIFICATE AND HAVE CAUSED THE SAME TO BE PLATTED INTO LOTS 1-2, THE SAME TO BE KNOWN AS 'PEINE SUBDIVISION' BEING A PORTION OF SECTION 2, TOWNSHIP 56 NORTH, RANGE 3 WEST, BOISE MERIDIAN, BONNER COUNTY, IDAHO, MORE SPECIFICALLY DESCRIBED AS FOLLOWS:

THENCE SOUTH 89'04'17" EAST, 752.19 FEET; THENCE SOUTH 89'04 1/° LASI, /52.19 FELI; THENCE SOUTH 00'37'24" WEST, 1208.21 FEETTO A; THENCE ALONG A NON-TANGENT CURVE TO THE LEFT AN ARC LENGTH OF261.24 FEET, A RADIUS OF675.00 FEET, THE CHORD OF WHICH IS NORTH 78'32'54" WEST, , 259.61 FEET; TO A; THENCE NORTH 89'28'20" WEST, 378.01 FEETTO A; THENCE ALONG A NON-TANGENT CURVE TO THE LEFT AN ARC LENGTH OF119.80 FEET, A RADIUS OF1040.95 FEET, THE CHORD OF WHICH IS SOUTH 87'34'03" WEST, , 119.73 FEET, TO A; THENCE MORTH 00'38'30" FAST 1170.46 FEETTO A; THENCE NORTH 00°38'30" EAST, 1170.46 FEETTO A ;

WHICH IS THE POINT OF BEGINNING, HAVING AN AREA OF 878308.28 SQUARE FEET, 20.163 ACRES

PEINE, CHRIS

COUNTY OF \_\_\_\_

NOTARY PUBLIC

RESIDING AT:

STATE OF

ACKNOWLEDGMENT

NOTARY PUBLIC FOR THE STATE OF \_\_\_\_\_

DATE

## PLANNING DIRECTOR

THIS PLAT HAS BEEN EXAMINED AND APPROVED THIS \_\_\_\_\_ DAY OF , 2024.

PLANNING DIRECTOR

### SURVEYOR'S CERTIFICATE

I, TYSON L.A. GLAHE, PLS 14879, STATE OF IDAHO. DO HEREBY CERTIFY THAT THIS PLAT WAS PREPARED BY ME OR UNDER MY DIRECTION AND IS BASED ON AN ACTUAL SURVEY LOCATED IN SECTION 2, TOWNSHIP 56 NORTH, RANGE 3 WEST, BOISE MERIDIAN, BONNER COUNTY, IDAHO, THAT THE DISTANCES, COURSES AND ANGLES ARE SHOWN CORRECTLY THEREON AND THAT THE MONUMENTS HAVE BEEN PLACED AND ALL LOT CORNERS PROPERLY SET AND THE SURVEY IS IN COMPLIANCES WITH ALL PROVISIONS OF APPLICABLE STATE LAW AND LOCAL OPDINANCES ORDINANCES.


> PREPARED FOR: JARED PEINE 7627 LAKESHORE DR.,

SAGLE, ID 83860

TYSON L.A. GLAHE, PLS 14879

DATE



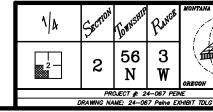

MY COMMISSION EXPIRES: \_\_\_\_\_

ON THIS DAY OF \_\_\_\_\_, 2024, BEFORE ME, THE UNDERSIGNED NOTARY PUBLIC, PERSONALLY APPEARED CHRIS PEINE, KNOWN OR IDENTIFIED TO ME TO BE THE INDIVIDUAL WHO EXECUTED THE FOREGOING INSTRUMENT.

## COUNTY SURVEYOR'S CERTIFICATE

| I HEREBY CERTIFY | THAT I HAVE EXAMIN | NED THE HEREIN PLA | T "PEINE          |
|------------------|--------------------|--------------------|-------------------|
| SUBDIVISION" AND | CHECKED THE PLAT   | AND COMPUTATIONS   | THEREON AND HAVE  |
|                  |                    | OF THE IDAHO STATE | E CODE PERTAINING |
| TO PLATS AND SU  | RVEYS HAVE BEEN M  | IET.               |                   |
|                  |                    |                    |                   |

DATED THIS \_\_\_\_\_ DAY OF \_\_\_\_\_, 2024.

BONNER COUNTY SURVEYOR

### SANITARY RESTRICTION

| ANITARY RESTRICTIONS AS REQUIRED BY IDAHO CODE, TIT | ILE 50, CHAPTER 13      |
|---|-------------------------|
| RE IN FORCE. NO OWNER SHALL CONSTRUCT ANY BUILDIN   | IG, DWELLING OR SHELTER |
| HICH NECESSITATES THE SUPPLYING OF WATER OR SEWA    |                         |
| ERSONS USING SUCH PREMISES UNTIL SANITARY RESTRICT  | TION REQUIREMENTS ARE   |
| ATISFIED.   |                         |

### WATER AND SEWER NOTE

| WATER | SERVICE: | WATER  | то | BE . | AN | INDIVIDU | AL | WELL |
|-------|----------|--------|----|------|----|----------|----|------|
| SEWER | SERVICE: | SEWAGE | TC | ) BE | IN | DIVIDUAL | SE | PTIC |

### COUNTY TREASURER'S CERTIFICATE

| HEREBY   | CERTIFY | THAT   | THE  | REQUI | IRED | TA | XES | ON  | THE  | HEF | REIN | DESCR | IBED |  |
|----------|---------|--------|------|-------|------|----|-----|-----|------|-----|------|-------|------|--|
| PROPERTY | HAVE    | BEEN F | ULLY | PAID  | UP   | то | AND | INC | LUDI | NG  | THE  | YEAR  |      |  |

DATED THIS \_\_\_\_\_ DAY OF \_\_\_\_\_ , 2024.

BONNER COUNTY TREASURER

## RECORDER'S CERTIFICATE

FILED THIS \_\_\_\_\_DAY OF \_\_\_\_\_, 2024, AT \_\_\_\_O'CLOCK \_\_.M., IN BOOK \_\_\_\_\_OF PLATS AT PAGE \_\_\_\_\_AT THE REQUEST OF GLAHE AND ASSOCIATES, INC., AS INSTRUMENT NO. \_\_\_\_\_

| ORECON WASHINGTON<br>PEINE<br>De EXHIBIT TDLG |                   | Sandpoint, Idaho 83864<br>208-265-4474           | 114G<br>Plot Date:<br>8/2/2024 | Sheet:<br>2 of    |  |  |
|---|-------------------|--|--------------------------------|-------------------|--|--|
| Ī   | OREGON WASHINGTON | PROFESSIONAL LAND SURVEYORS<br>303 Church Street | Checked By:<br>TLAG            | Drawn By:<br>TDLG |  |  |
| 3   |                   | GLAHE & ASSOCIATES                               | Scale:<br>N/A                  |                   |  |  |
| NGB   | MONTANA IDAHO     | PEINE SUBDI                                      |                                |                   |  |  |
|   | FEE               | PLACE RECORDING<br>LABEL HERE                    |                                |                   |  |  |
| \$  | FEE               |  |                                |                   |  |  |
| COL   | JNTY RECORDER     | BY DEPUTY  |                                |                   |  |  |
|   |                   |  |                                |                   |  |  |

" 2 of 2